


NOTES: -
 BENCH MARK - PK IN LEAD, NW CURB, ORCHARD & HOOVER - ELEV. 839.74
 CONSTRUCTION TO BE IN ACCORDANCE WITH STDS. & SPECIFICATIONS OF CITY OF RIVERSIDE DEPT. OF PUBLIC WORKS.
 4" HOUSE CONNECTIONS TO BE LOCATED AS SHOWN (WYE CONNECTIONS ONLY IN PROPOSED UNITS 2 & 3 AT STATIONS AS SHOWN)
 WYE CONNECTIONS TO BE LOCATED AT STATIONS SHOWN OR NEXT LOWER PIPE LENGTH.

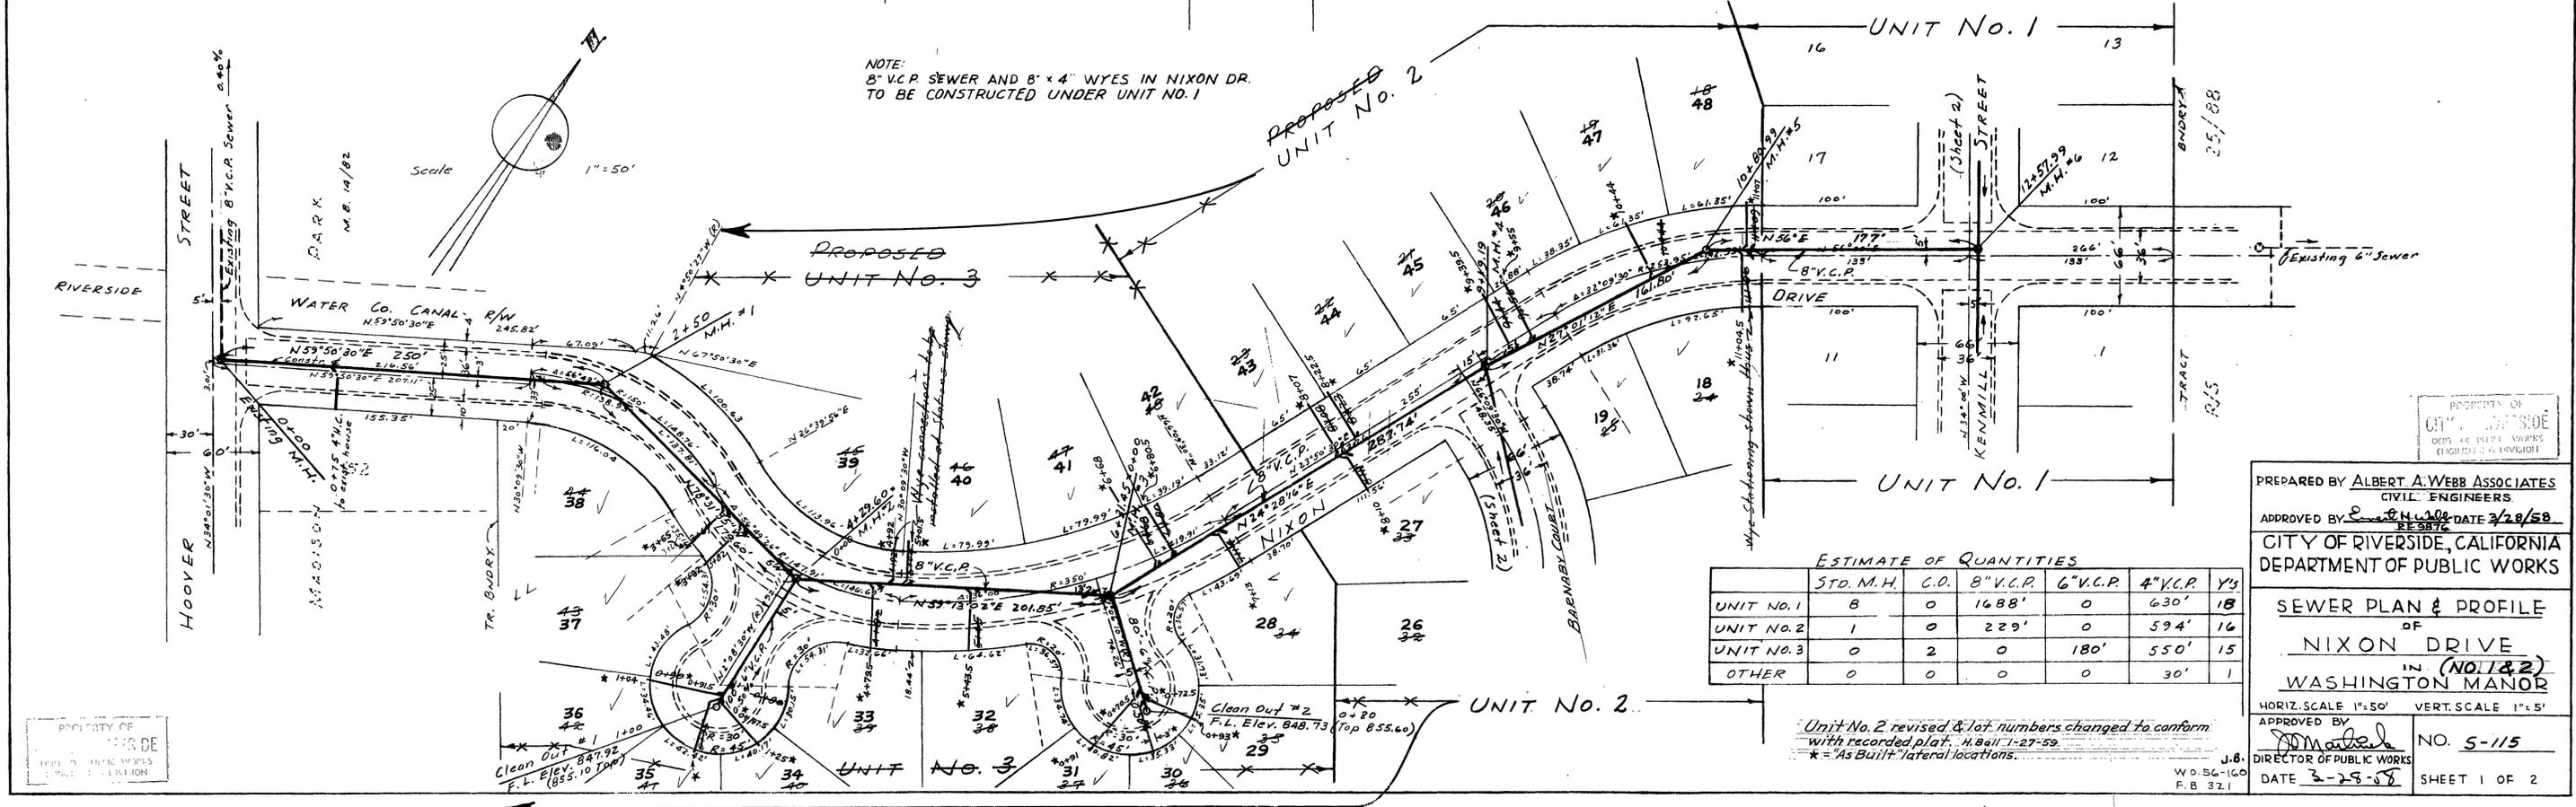

NOTE:
 8" V.C.P. SEWER AND 8" x 4" WYES IN NIXON DR. TO BE CONSTRUCTED UNDER UNIT NO. 1

ESTIMATE OF QUANTITIES

	STD. M.H.	C.O.	8" V.C.P.	6" V.C.P.	4" V.C.P.	Y's
UNIT NO. 1	8	0	1688'	0	630'	18
UNIT NO. 2	1	0	229'	0	594'	16
UNIT NO. 3	0	2	0	180'	550'	15
OTHER	0	0	0	0	30'	1

Unit No. 2 revised & lot numbers changed to conform with recorded plat. H. Ball 1-27-59.
 * = "As Built" lateral locations.

PREPARED BY ALBERT A. WEBB ASSOCIATES
 CIVIL ENGINEERS
 APPROVED BY *[Signature]* DATE 3/28/58
 CITY OF RIVERSIDE, CALIFORNIA
 DEPARTMENT OF PUBLIC WORKS

SEWER PLAN & PROFILE
 OF
 NIXON DRIVE
 IN (NO. 1 & 2)
 WASHINGTON MANOR

HORIZ. SCALE 1"=50' VERT. SCALE 1"=5'
 APPROVED BY *[Signature]* NO. 5-115
 DIRECTOR OF PUBLIC WORKS
 DATE 3-28-58 SHEET 1 OF 2


PROFILE

NO.	DATE

PLAN

NO.	DATE

PROPERTY OF
 CITY OF RIVERSIDE
 DEPT. OF PUBLIC WORKS
 ENGINEER: J. A. HANCOCK


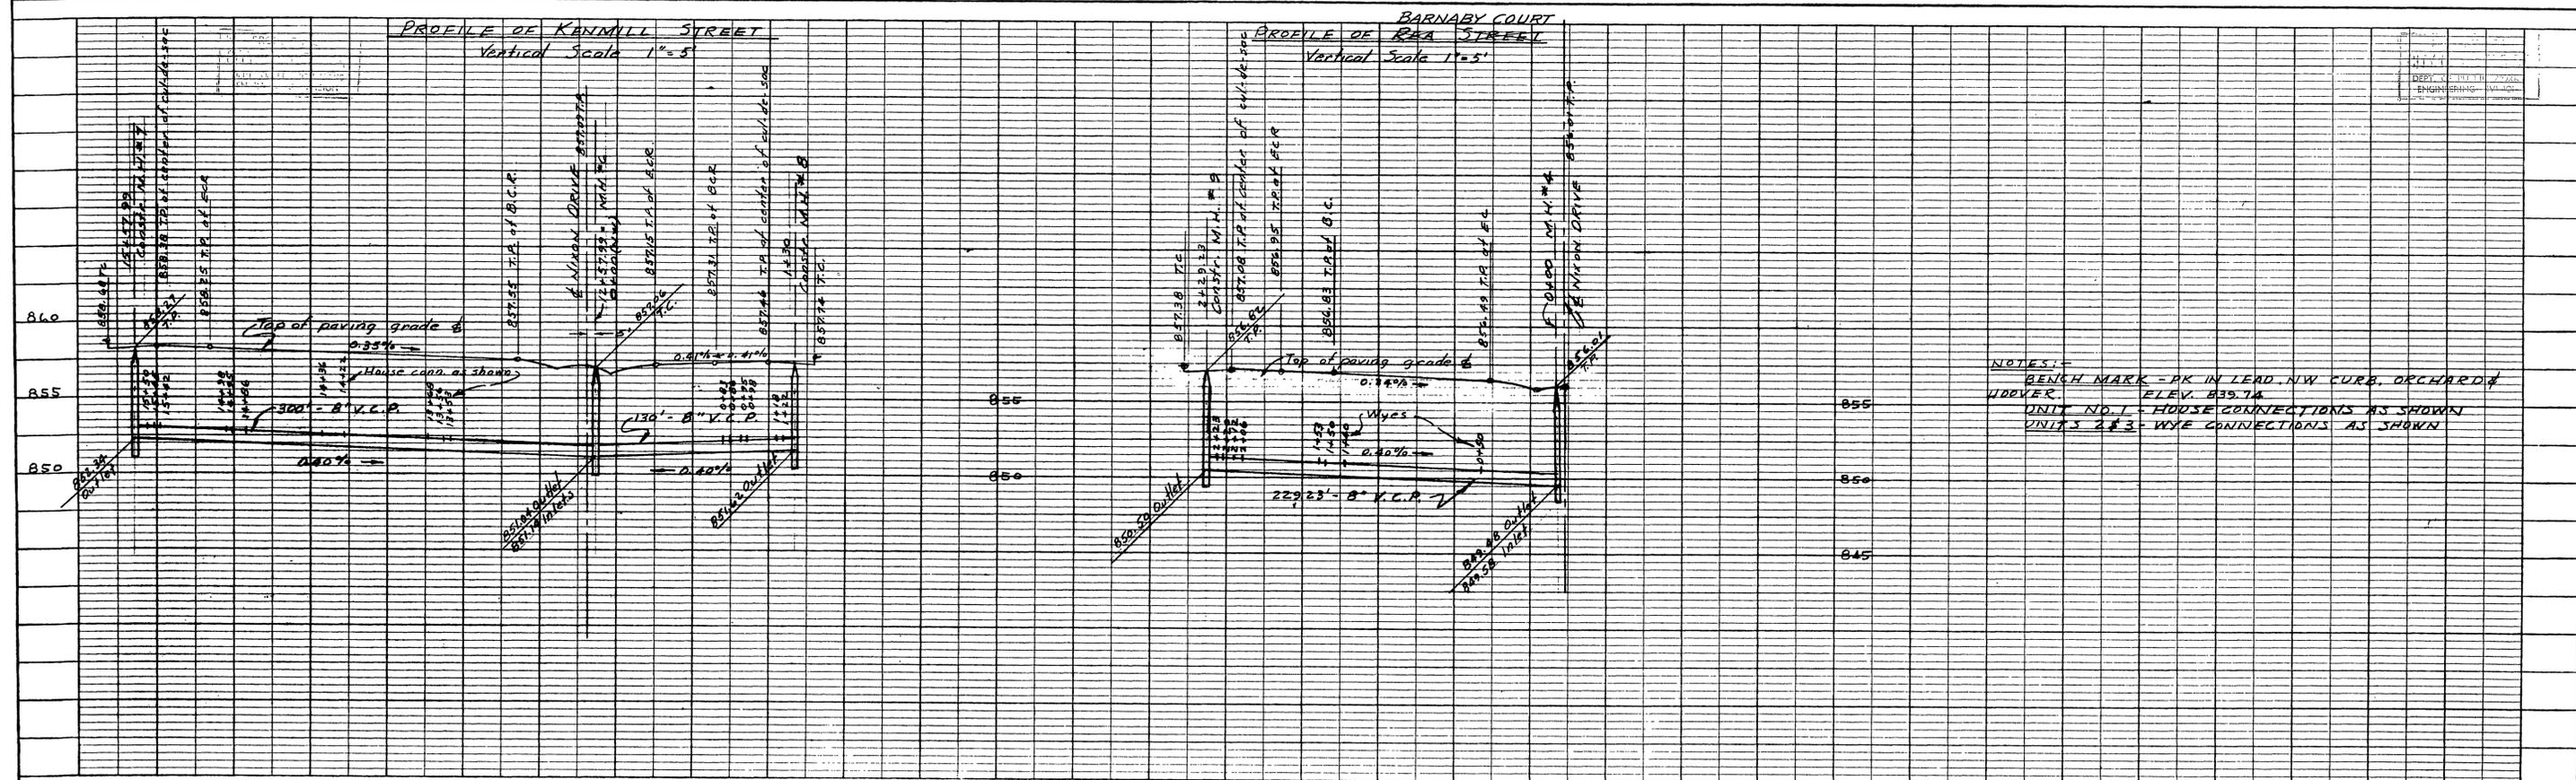


NOTES:
 BENCH MARK - PK IN LEAD NW CURB, ORCHARD
 WYER. ELEV. 855.74
 UNIT NO. 1 - HOUSE CONNECTIONS AS SHOWN
 UNIT NO. 2 - WYE CONNECTIONS AS SHOWN

UNIT No. 1

PROPOSED UNIT No. 2

To be constructed Under Unit # 2

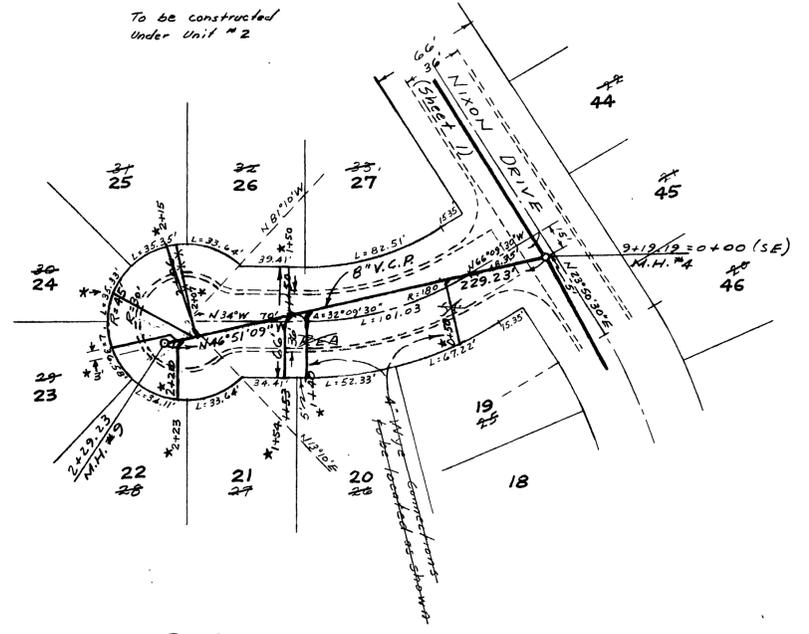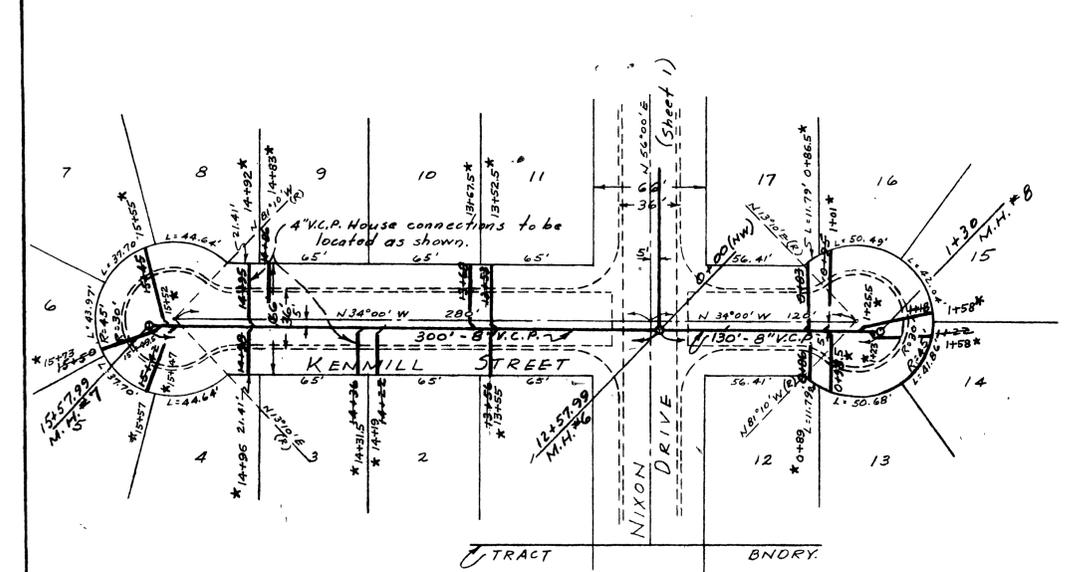

REA St. CHANGED TO BARNABY COURT.

Scale 1" = 50'



PREPARED BY ALBERT A. WEBB ASSOCIATES
 CIVIL ENGINEERS
 APPROVED BY *[Signature]* DATE 3/29/58
 R.E. 9876
 CITY OF RIVERSIDE, CALIFORNIA
 DEPARTMENT OF PUBLIC WORKS

SEWER PLAN & PROFILE
 OF BARNABY CT.
 KENMILL STREET & REA STREET
 IN (NO. 1 & 2)
 WASHINGTON MANOR

HORIZ. SCALE 1" = 50' VERT. SCALE 1" = 5'
 APPROVED BY *[Signature]* NO. 5-115
 J.B. DIRECTOR OF PUBLIC WORKS
 W.O. 56-160 F.B. 321 DATE 3-29-58 SHEET 2 OF 2

Unit No. 2 revised & lot numbers changed to conform with recorded plat. H.B. 11-27-59
 * = 'As Built' lateral locations.

PROFILE	
DATE	
BY	
CHECKED	
DATE	

PLAN	
DATE	
BY	
CHECKED	
DATE	



NO. 5-115